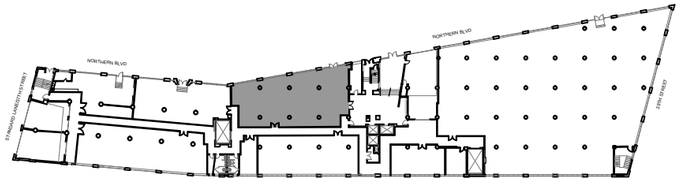

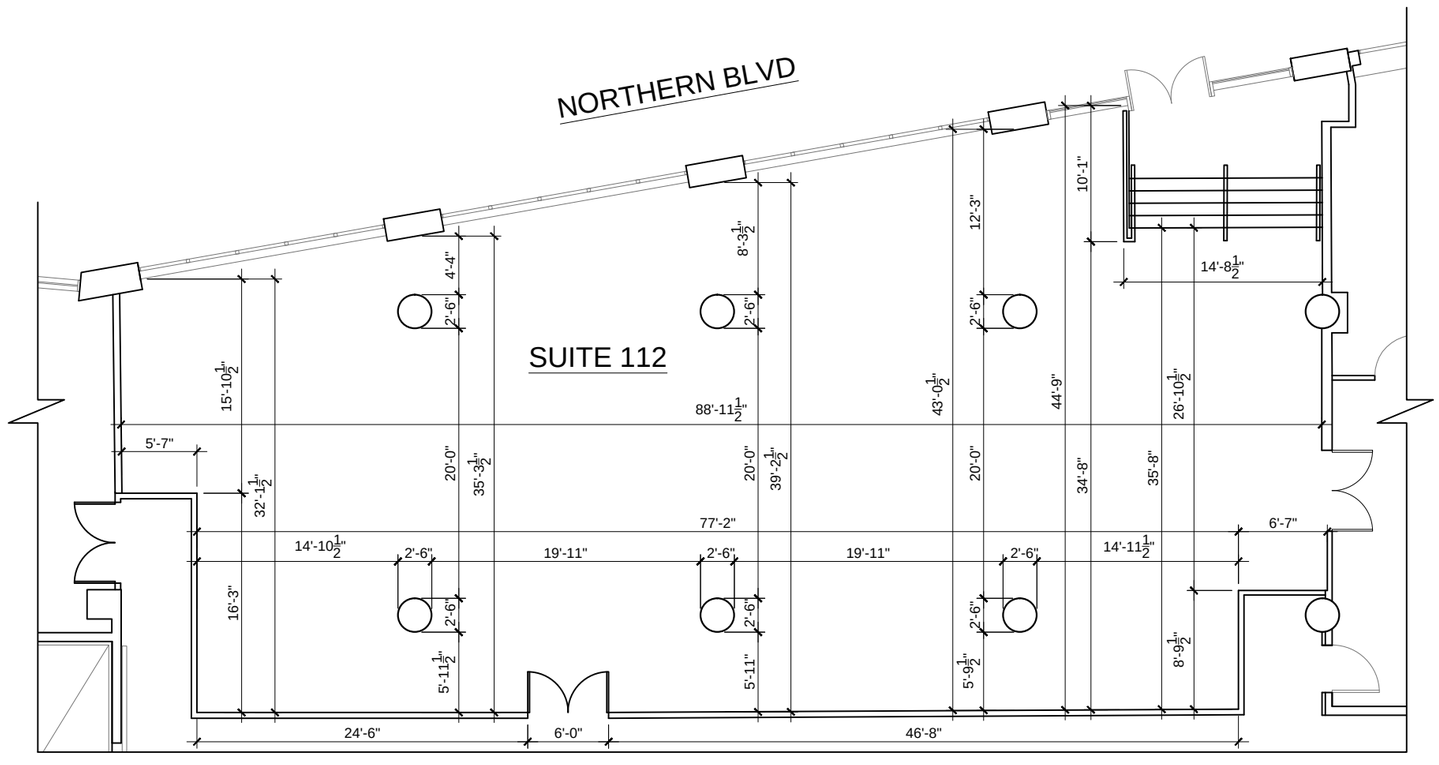

SCALE: 3/32" = 1'-0"

RXR CONSTRUCTION & DEVELOPMENT

FIRST FLOOR, SUITE 112

ASBUILT

FIRST FLOOR, SUITE 112
37-18 NORTHERN BLVD
LONG ISLAND CITY, NEW YORK

PROJECT LOCATION		
G:\Construction\Manhattan\37-18 SMP Building\Base Building\Demising Plans\		
FILE NAME	PLOT DATE	
37-18-01-PD.dwg	Apr 30, 2018 - 1:46pm	
DATE	Apr 30, 18	DRAWING NO.
DRAWN BY	mmunoz	DS-1